


PSM72109
 E: 490729.557
 N: 7001736.656
 RL: 30.422m

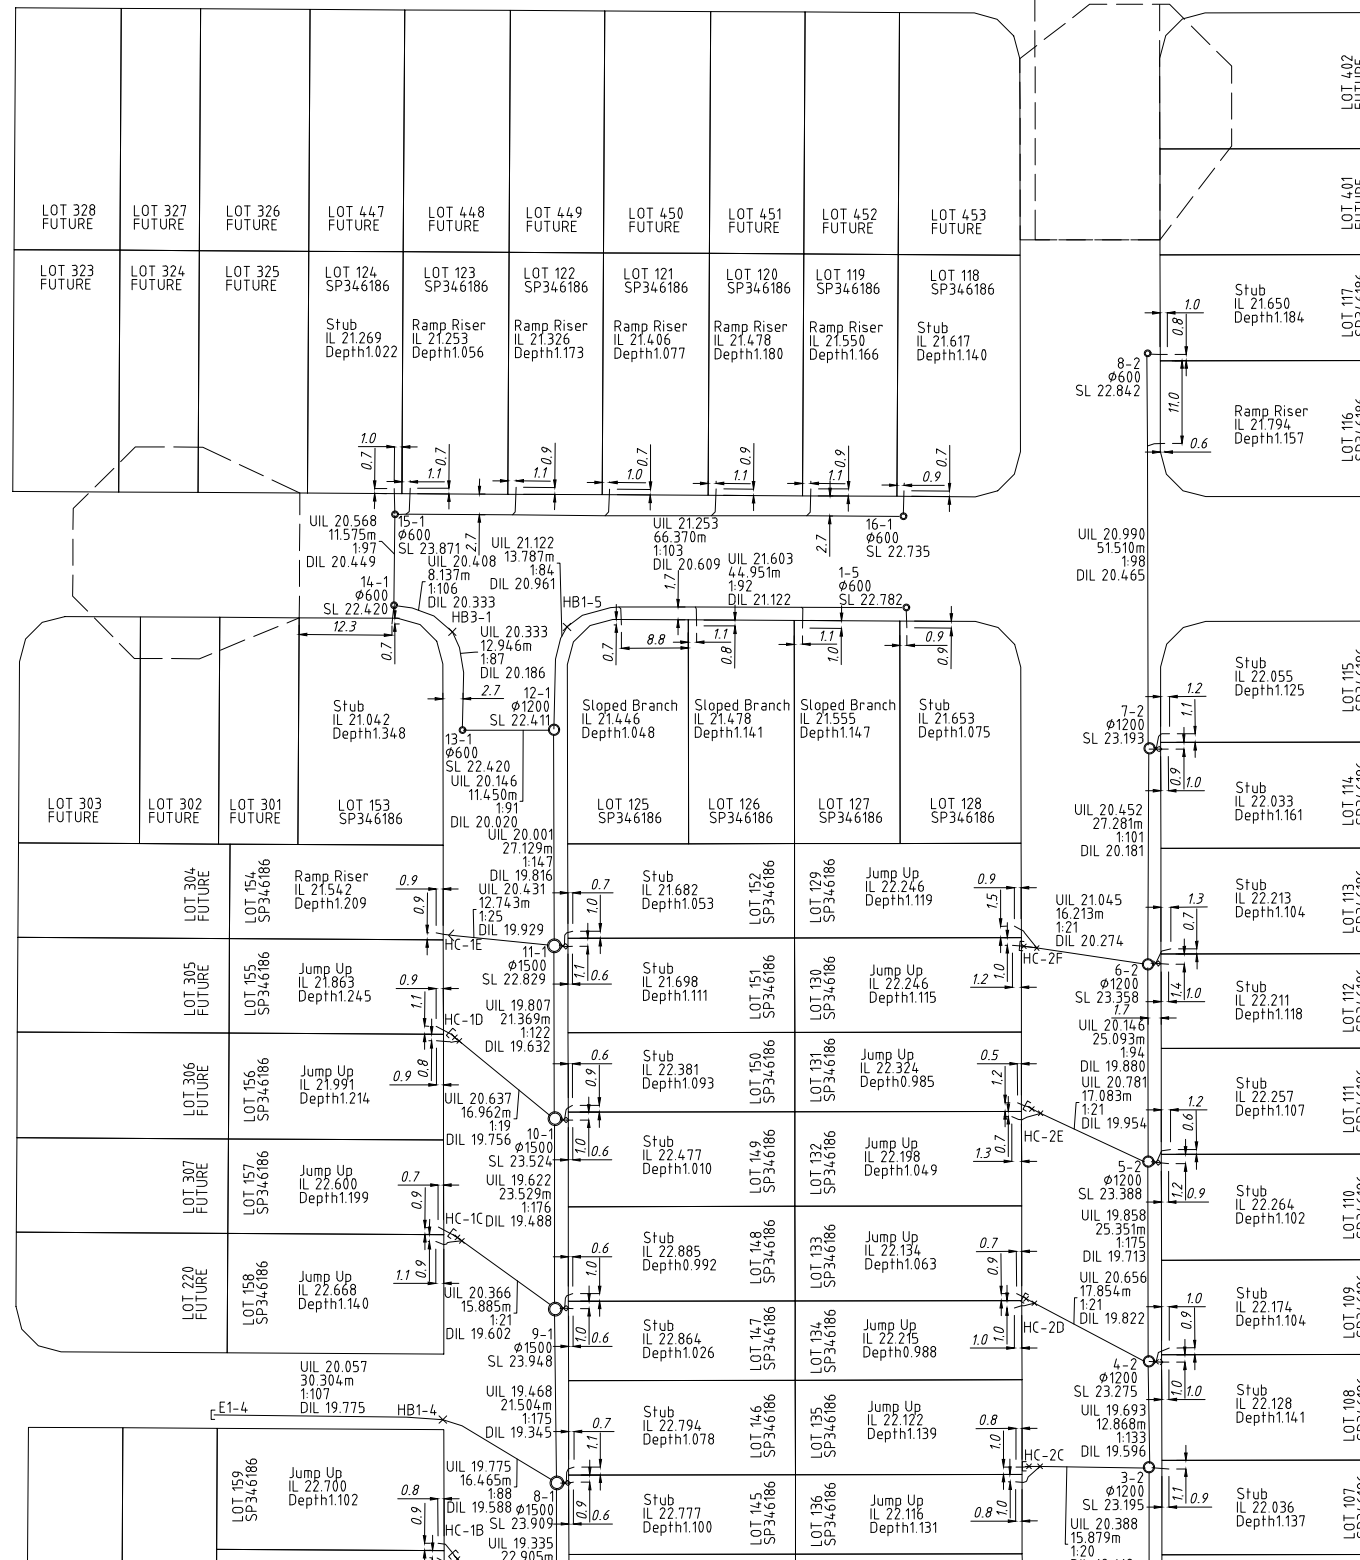

ENGINEER'S CERTIFICATION

I, _____, hereby certify that:

- The information contained in this drawing / document is in compliance with approved drawings and design.
- The new water and sewerage works defined by this drawing have been designed and constructed in accordance with the SEQ Code.
- This represents an accurate record of as-constructed works.
- I accept responsibility for the information contained in this drawing / document.


RPEQ (signature) RPEQ No. _____ Date: _____

REGISTERED SURVEYOR'S CERTIFICATION

I, _____, hereby certify that the vertical and horizontal locations and dimensions shown on this plan are a true and correct record and were located by survey.

Registered Surveyor (sig) Reg. Surveyor No. _____ Date: _____

COORDINATE DATUM NOTE:
 HORIZONTAL COORDINATES (E, N) SUPPLIED ARE MAPPING GRID OF AUSTRALIA (MGA), ZONE 56 BASED ON THE UNIVERSAL TRANSVERSE MERCATOR PROJECTION AND THE GEOCENTRIC DATUM OF AUSTRALIA 2020.

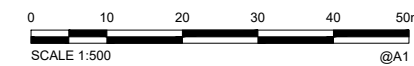

AS CONSTRUCTED

A1

INDEX	DATE	REVISIONS	DRAWN	CHECKED	PASSED	INITIALS	DATE
1	08/04/2025	INITIAL ISSUE	VO	LS	LS		



DRAWN	VO	08/04/2025
CHECKED	LS	08/04/2025
PASSED	LS	08/04/2025

Brisbane Office
 Level 11
 18 Little Cribb Street
 Milton QLD 4064
 PO Box 1399
 Milton
 QLD 4064
 P: (07) 3842 1000
 F: (07) 3842 1001
 E: info@landpartners.com.au
 W: www.landpartners.com.au

202302385751
 34 CRAIG ROAD, UPPER CABOOLTURE
 PROPOSED RESIDENTIAL DEVELOPMENT STAGE 1
 AS CONSTRUCTED SEWER

SHEET 1 OF 4 SHEETS	SCALE 1:500
REVISION DATE 08/04/2025	REVISION 1
DISCIPLINE CODE C	
DRAWING NO. U-2024-5339	

PSM72109
 E: 490729557
 N: 7001736.656
 RL: 30.422m

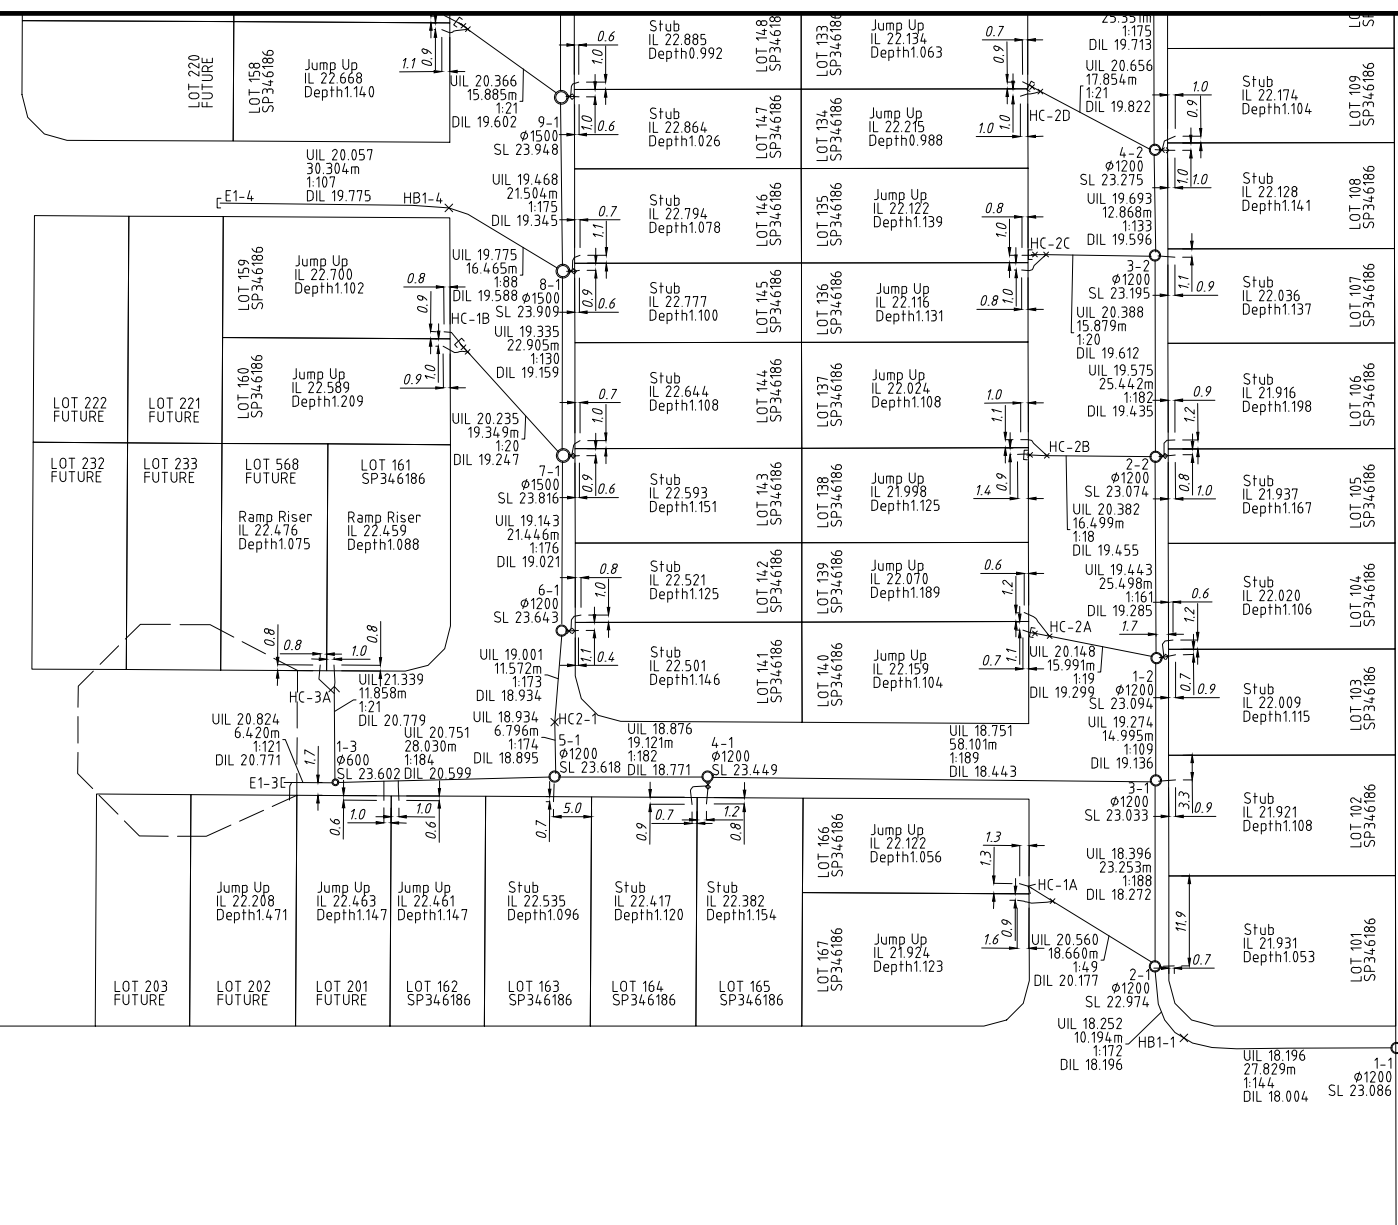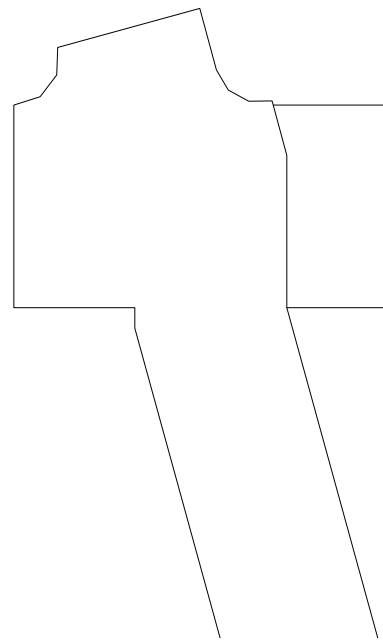


12
 RP866105

3
 SP199925

ENGINEER'S CERTIFICATION
 I, _____, hereby certify that:
 1. The information contained in this drawing / document is in compliance with approved drawings and design.
 2. The new water and sewerage works defined by this drawing have been designed and constructed in accordance with the SEQ Code.
 3. This represents an accurate record of as-constructed works.
 4. I accept responsibility for the information contained in this drawing / document.
 RPEQ (signature) RPEQ No. _____ Date: _____

REGISTERED SURVEYOR'S CERTIFICATION
 I, _____, hereby certify that the vertical and horizontal locations and dimensions shown on this plan are a true and correct record and were located by survey.
 Registered Surveyor (sig) Reg. Surveyor No. _____ Date: _____

COORDINATE DATUM NOTE:
 HORIZONTAL COORDINATES (E, N) SUPPLIED ARE MAPPING GRID OF AUSTRALIA (MGA), ZONE 56 BASED ON THE UNIVERSAL TRANSVERSE MERCATOR PROJECTION AND THE GEOCENTRIC DATUM OF AUSTRALIA 2020.

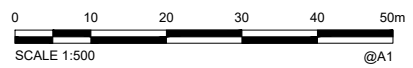

AS CONSTRUCTED

A1	INDEX	DATE	INITIALS	REVISIONS	DRAWN	CHECKED	PASSED	INITIALS	DATE
	1	08/04/2025	VO	LS	LS				


DRAWN	VO	08/04/2025
CHECKED	LS	08/04/2025
PASSED	LS	08/04/2025



Unitywater
 202302385751
 34 CRAIG ROAD, UPPER CABOOLTURE
 PROPOSED RESIDENTIAL DEVELOPMENT STAGE 1
 AS CONSTRUCTED SEWER

SHEET 2 OF 4 SHEETS	SCALE 1:500
REVISION DATE 08/04/2025	REVISION 1
DISCIPLINE CODE C	
DRAWING NO. U-2024-5339	

PSM72109
 E: 490729.557
 N: 7001736.656
 RL: 30.422m

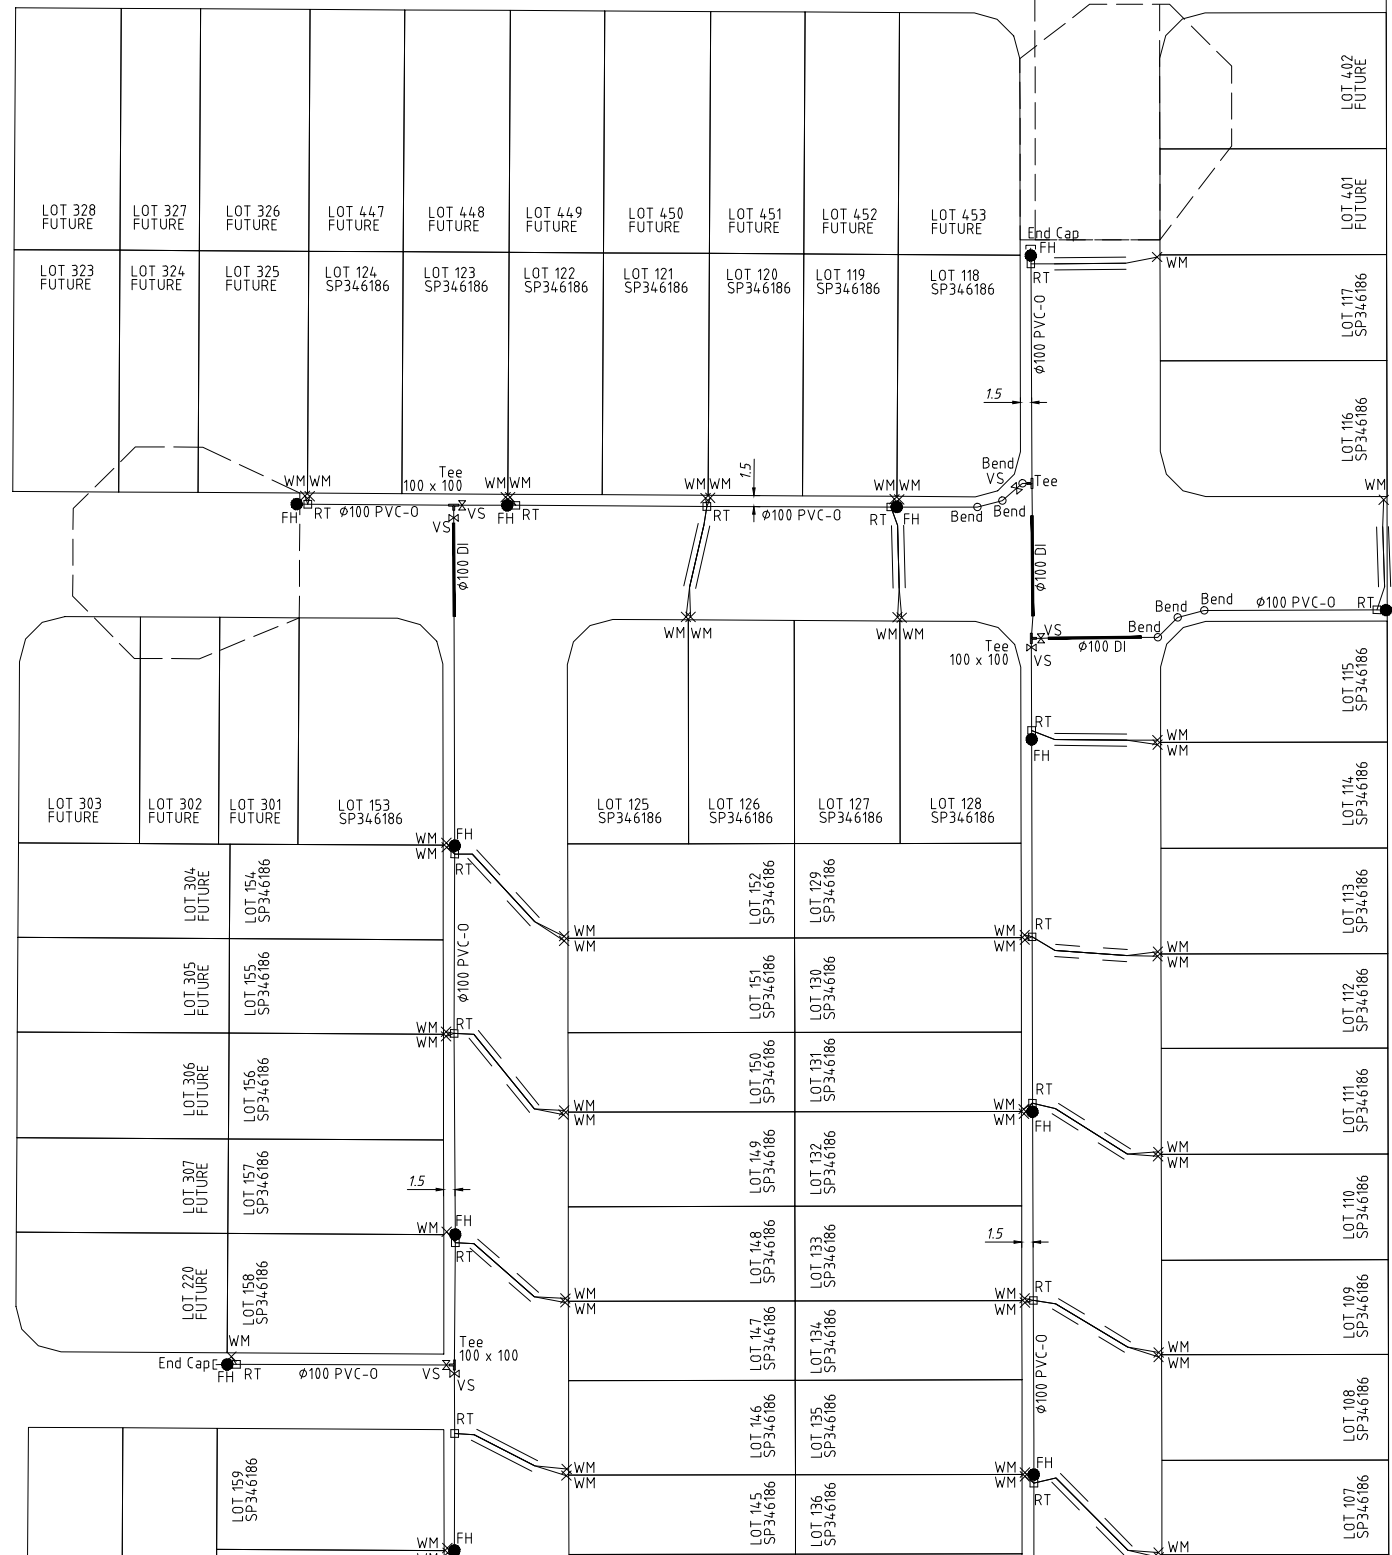

ENGINEER'S CERTIFICATION

I, _____, hereby certify that:

- The information contained in this drawing / document is in compliance with approved drawings and design.
- The new water and sewerage works defined by this drawing have been designed and constructed in accordance with the SEQ Code.
- This represents an accurate record of as-constructed works.
- I accept responsibility for the information contained in this drawing / document.

RP/EG (signature) RP/EG No. _____ Date: _____


REGISTERED SURVEYOR'S CERTIFICATION

I, _____, hereby certify that the vertical and horizontal locations and dimensions shown on this plan are a true and correct record and were located by survey.

Registered Surveyor (Sig) Reg. Surveyor No. _____ Date: _____

COORDINATE DATUM NOTE:
 HORIZONTAL COORDINATES (E, N) SUPPLIED ARE MAPPING GRID OF AUSTRALIA (MGA), ZONE 56 BASED ON THE UNIVERSAL TRANSVERSE MERCATOR PROJECTION AND THE GEOCENTRIC DATUM OF AUSTRALIA 2020.

12
 RP866105

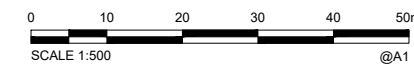

AS CONSTRUCTED

A1

INDEX	DATE	REVISIONS	DRAWN	CHECKED	PASSED
1	08/04/2025	INITIAL ISSUE	VO	LS	LS

INITIALS	DATE
DRAWN VO	08/04/2025
CHECKED LS	08/04/2025
PASSED LS	08/04/2025

LANDPARTNERS
 Surveyors and Planners

Erisbane Office
 Level 1,
 18 Little Cribb Street
 Milton QLD 4064

PO Box 1399
 Milton
 QLD 4064

ph (07) 3842 1000
 f (07) 3842 1001
 e info@landpartners.com.au
 www.landpartners.com.au




Unitywater

202302385751
 34 CRAIG ROAD, UPPER CABOOLTURE
 PROPOSED RESIDENTIAL DEVELOPMENT STAGE 1
 AS CONSTRUCTED WATER

SHEET 3 OF 4 SHEETS	SCALE 1:500
REVISION DATE 08/04/2025	REVISION 1
DISCIPLINE CODE C	
DRAWING NO. U-2024-5339	

PSM72109
 E: 490729557
 N: 7001736.656
 RL: 30.422m

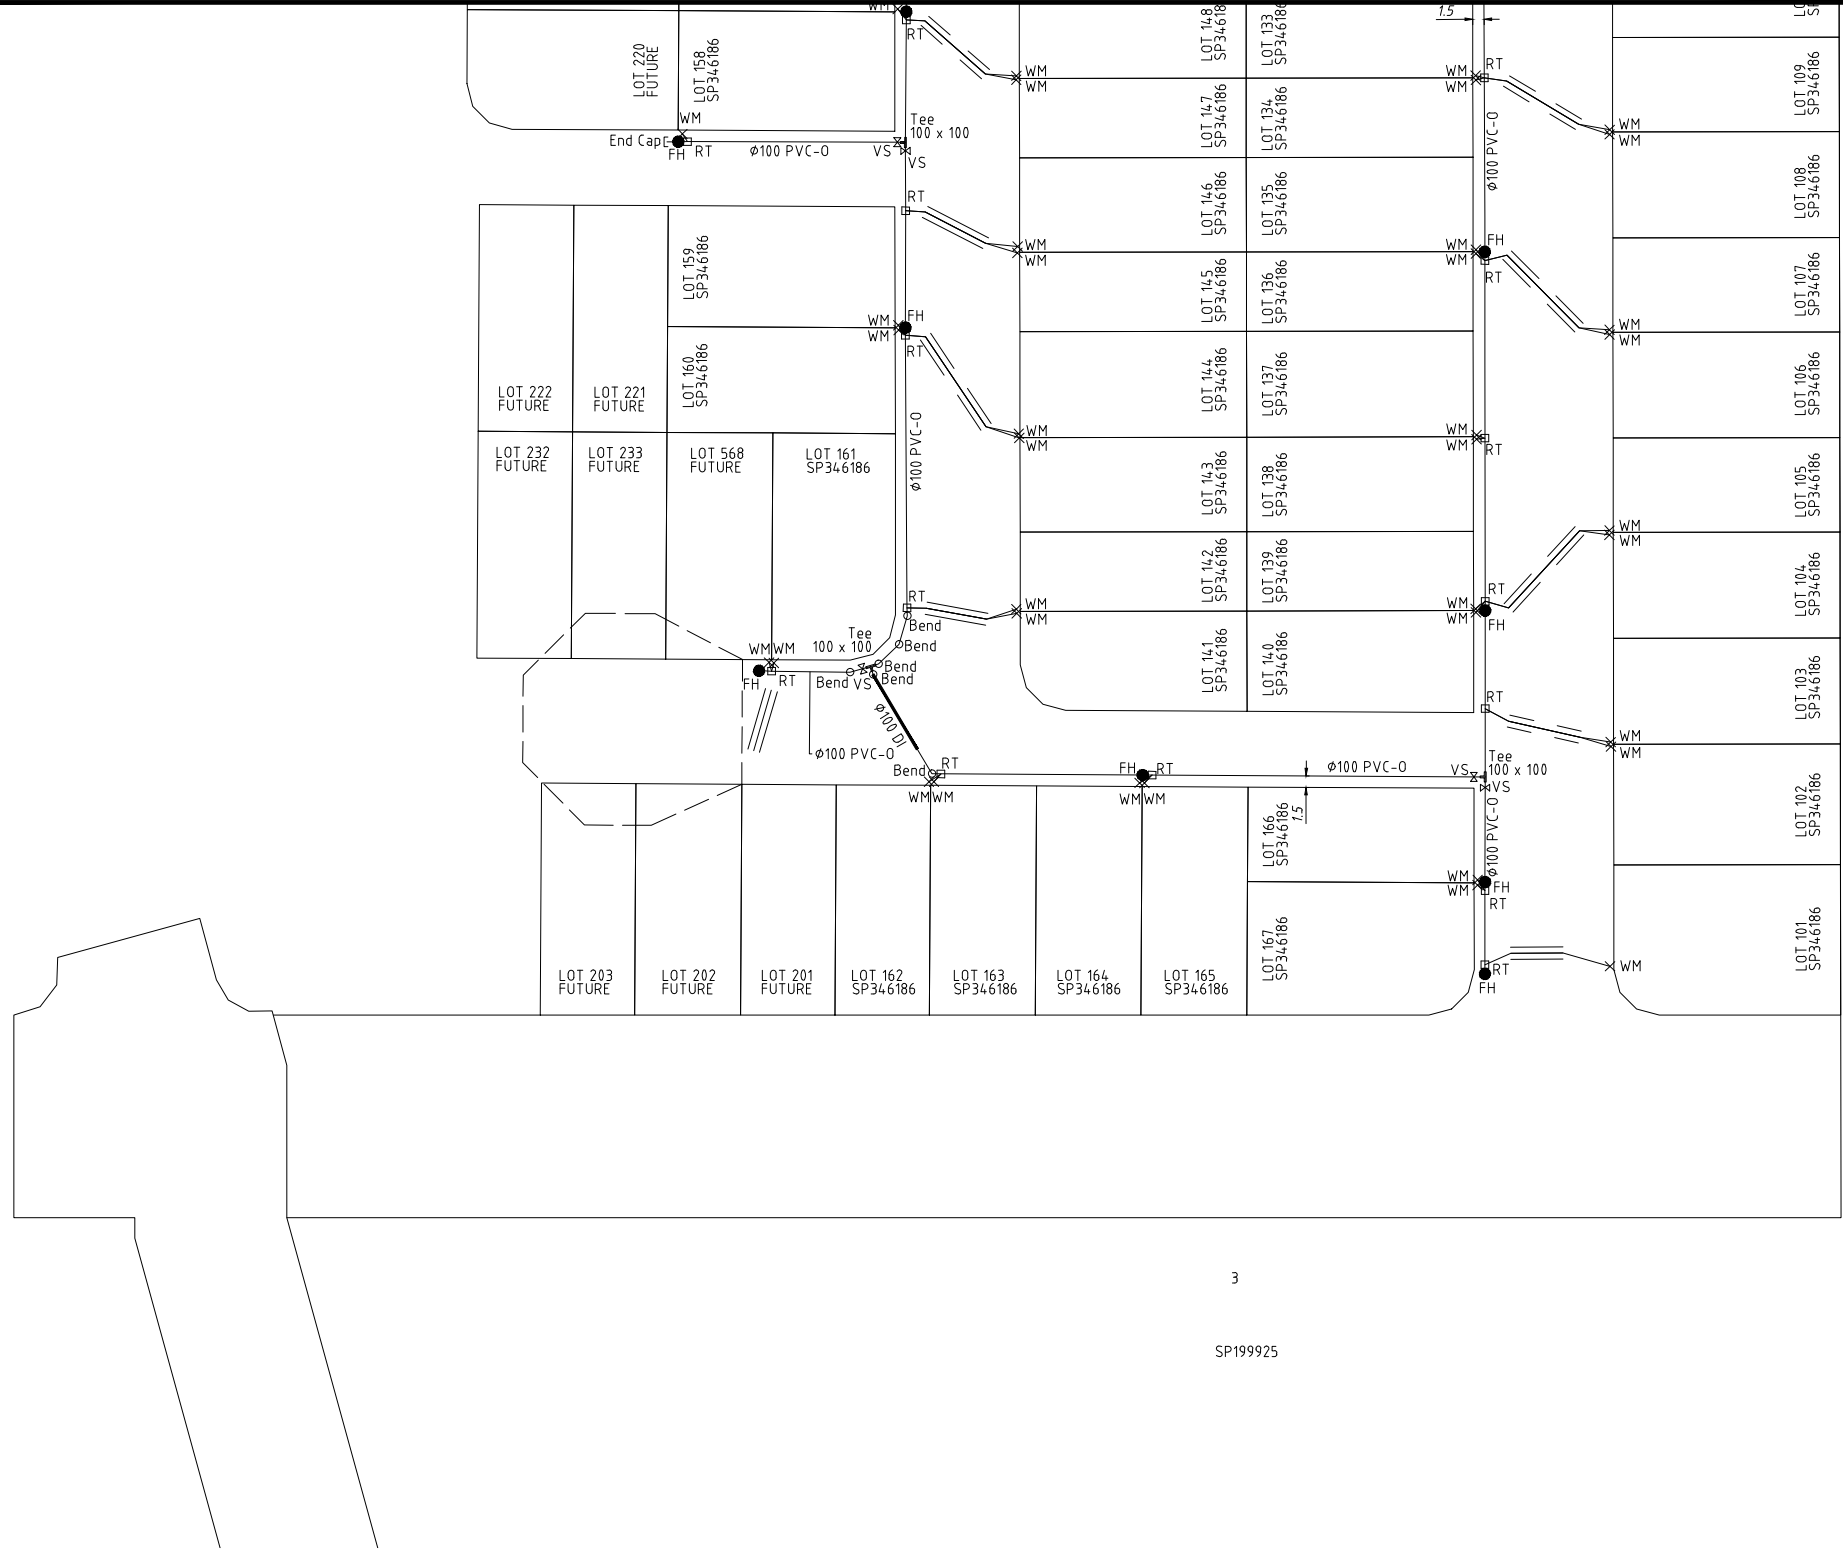

12
 RP866105

3
 SP199925

ENGINEER'S CERTIFICATION

I, _____, hereby certify that:
 1. The information contained in this drawing / document is in compliance with approved drawings and design.
 2. The new water and sewerage works defined by this drawing have been designed and constructed in accordance with the SEQ Code.
 3. This represents an accurate record of as-constructed works.
 4. I accept responsibility for the information contained in this drawing / document.

RP866 (signature) RP866 No. _____ Date: _____


REGISTERED SURVEYOR'S CERTIFICATION

I, _____, hereby certify that the vertical and horizontal locations and dimensions shown on this plan are a true and correct record and were located by survey.

Registered Surveyor (sig) Reg. Surveyor No. _____ Date: _____

COORDINATE DATUM NOTE:

HORIZONTAL COORDINATES (E, N) SUPPLIED ARE MAPPING GRID OF AUSTRALIA (MGA), ZONE 56 BASED ON THE UNIVERSAL TRANSVERSE MERCATOR PROJECTION AND THE GEOCENTRIC DATUM OF AUSTRALIA 2020.

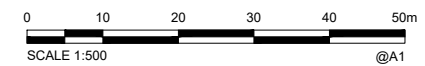

AS CONSTRUCTED

A1

INDEX	DATE	REVISIONS	DRAWN	CHECKED	PASSED
1	08/04/2025	INITIAL ISSUE	VO	LS	LS

INITIALS	DATE
DRAWN VO	08/04/2025
CHECKED LS	08/04/2025
PASSED LS	08/04/2025

Brisbane Office
 Level 11
 18 Little Cribb Street
 Milton QLD 4064
 PO Box 1399
 Milton
 QLD 4064
 P: (07) 3842 1000
 F: (07) 3842 1001
 E: info@landpartners.com.au
 W: www.landpartners.com.au



Unitywater

202302385751
 34 CRAIG ROAD, UPPER CABOOLTURE
 PROPOSED RESIDENTIAL DEVELOPMENT STAGE 1
 AS CONSTRUCTED SEWER

SHEET 4 OF 4 SHEETS	SCALE 1:500
REVISION DATE 08/04/2025	REVISION 1
DISCIPLINE CODE C	
DRAWING NO. U-2024-5339	