



LEGEND

- SEWER END CAP
- △ SEWER WYE
- SEWER RADIAL BEND
- ◎ SEWER MAINTENANCE SHAFT
- Ⓜ SEWER MAINTENANCE HOLE

NOTES

- ALL SEWER HOUSE CONNECTION PIPES ARE Ø110 PE-100, CLASS 'SDR21' U.N.O.
- ALL SEWER RETICULATION PIPES ARE Ø160 PE-100, CLASS 'SDR21' U.N.O.



ENGINEER'S CERTIFICATION

REGISTERED CADASTRAL SURVEYOR (QLD) CERTIFICATION

LandPartners Pty Ltd, hereby certify that the horizontal and vertical locations, and dimensions shown on this plan are a true and correct record of the As Constructed information.

100

4118 8/07/202

COORDINATE DATUM NOTE:

HORIZONTAL COORDINATES(E,N) SUPPLIED ARE MAPPING GRID OF AUSTRALIA(MGA), ZONE 56 BASED ON THE UNIVERSAL TRANSVERSE MERCATOR PROJECTION AND THE GEOCENTRIC DATUM OF AUSTRALIA 1994.

0 10 20 30 40 50m
SCALE 1:5000 @A1

AS CONSTRUCTED

A1

1 28-07-2025 INITIAL ISSUE

			DRAWN	MJK	28-
			CHECKED	LS	28-
	MJK	LS	PASSED	LS	28-

MN
LANDPARTNER

Brisbane Office
Level 1
18 Little Cribb Street
Milton QLD 4064
p: (07) 3842 1000
e: brisbane@mnglandpartners.com
w: www.landpartners.com.au

 Unitywater

Unitywater

2023023857S2
34 CRAIG ROAD, UPPER CABOOLTURE
PROPOSED RESIDENTIAL DEVELOPMENT STAGE 2
AS CONSTRUCTED SEWER

1 OF 2	Sheets	SCALE 1:500
ON DATE	28-07-2025	REVISION 1
LINE CODE	C	

NG NO.
2024-5340




LEGEND

- (H) WATER FIRE HYDRANT
- (T) WATER TEE
- (M) WATER METER
- (B) WATER BEND
- WATER VALVE
- (R) WATER READY TAP
- (O) WATER REDUCER
- == CONDUIT/CROSSING

NOTES:

- WATER SERVICE CONDUIT CROSSINGS ARE $\phi 100$ PVC-U, CLASS 'PN9' AND SWJ
- WATER SERVICE PIPES NOT CROSSING ROADS ARE $\phi 25$ PE AND CLASS 'PN16'.
- WATER SERVICE PIPES CROSSING ROADS ARE $\phi 32$ PE AND CLASS 'PN16'.

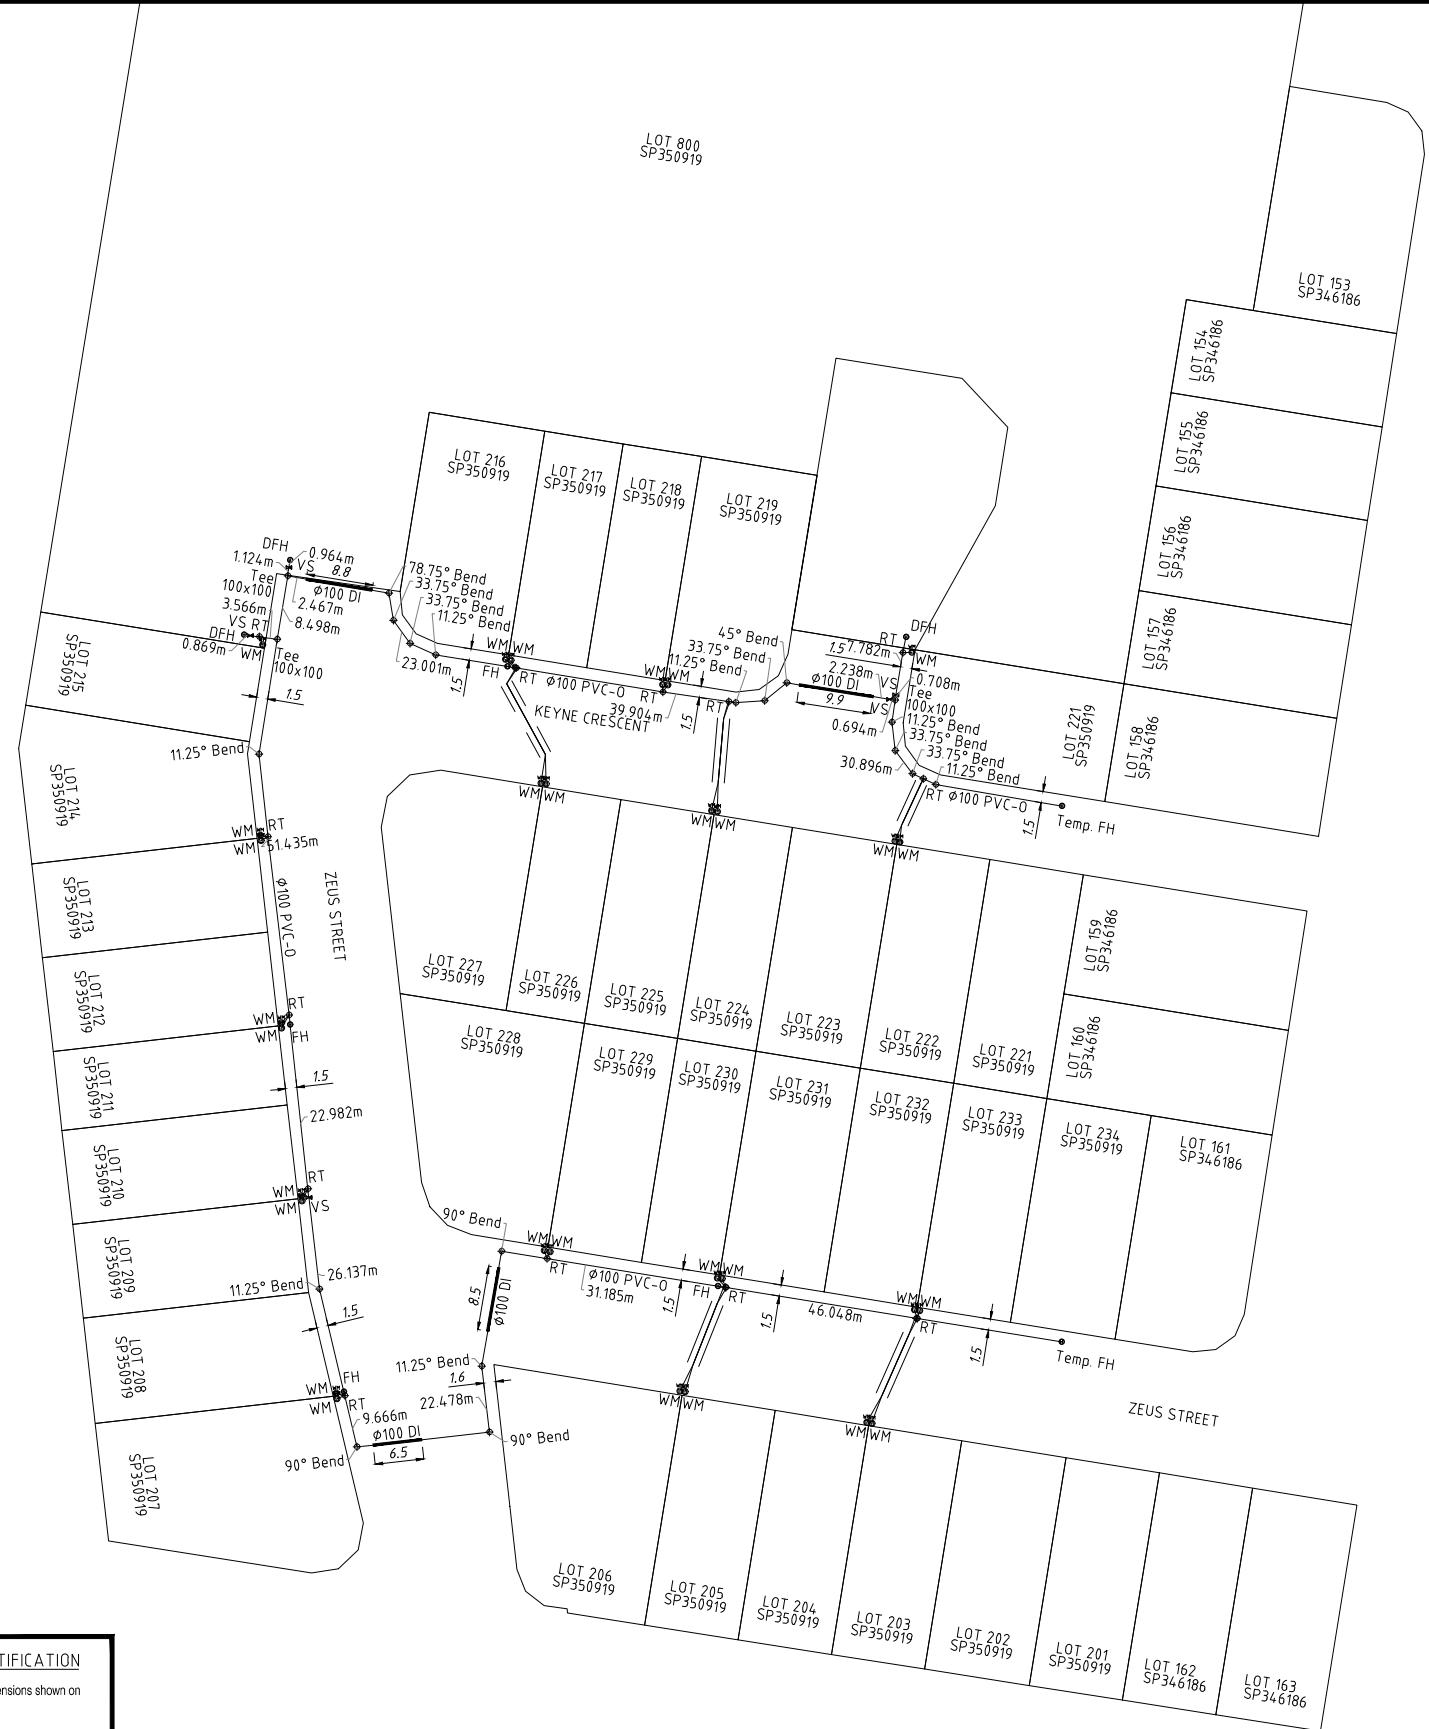

ENGINEER'S CERTIFICATION

REGISTERED CADASTRAL SURVEYOR (QLD) CERTIFICATION

LandPartners Pty Ltd, hereby certify that the horizontal and vertical locations, and dimensions shown on this plan are a true and correct record of the As Constructed information.

 4118
Authorised Delegate 28/07/2023
LandPartners Pty Ltd Rego No. Date
Registered Old Surveyor Corporation

COORDINATE DATUM NOTE:

HORIZONTAL COORDINATES(E,N) SUPPLIED ARE MAPPING GRID OF AUSTRALIA(MGA), ZONE 56 BASED ON THE UNIVERSAL TRANSVERSE MERCATOR PROJECTION AND THE GEOCENTRIC DATUM OF AUSTRALIA 1994.

A scale bar and north arrow are located in the bottom right corner of the map. The scale bar is a horizontal line with tick marks at 0, 10, 20, 30, 40, and 50 meters. Below the scale bar, the text 'SCALE 1:500' is written. To the right of the scale bar, the text '@A1' is written.

AS CONSTRUCTED

A1

A1								
							DRAWN MJK	28-07-2023
							CHECKED LS	28-07-2023
1	28-07-2025	INITIAL ISSUE		MJK	LS	LS	PASSED LS	28-07-2023
INDEX	DATE	REVISIONS		DRAWN	CHECKED	PASSED	INITIALS	DATE

MN
LANDPARTNER

Perth | Brisbane | Melbourne | Sydney | Broome | South West W

 Unitywater

Unitywater

202302385752
34 CRAIG ROAD, UPPER CABOOLTURE
PROPOSED RESIDENTIAL DEVELOPMENT STAGE 2
AS CONSTRUCTED WATER

1 OF 2	Sheets	Scale 1:500
On Date	28-07-2025	Revision 1
Line Code	C	