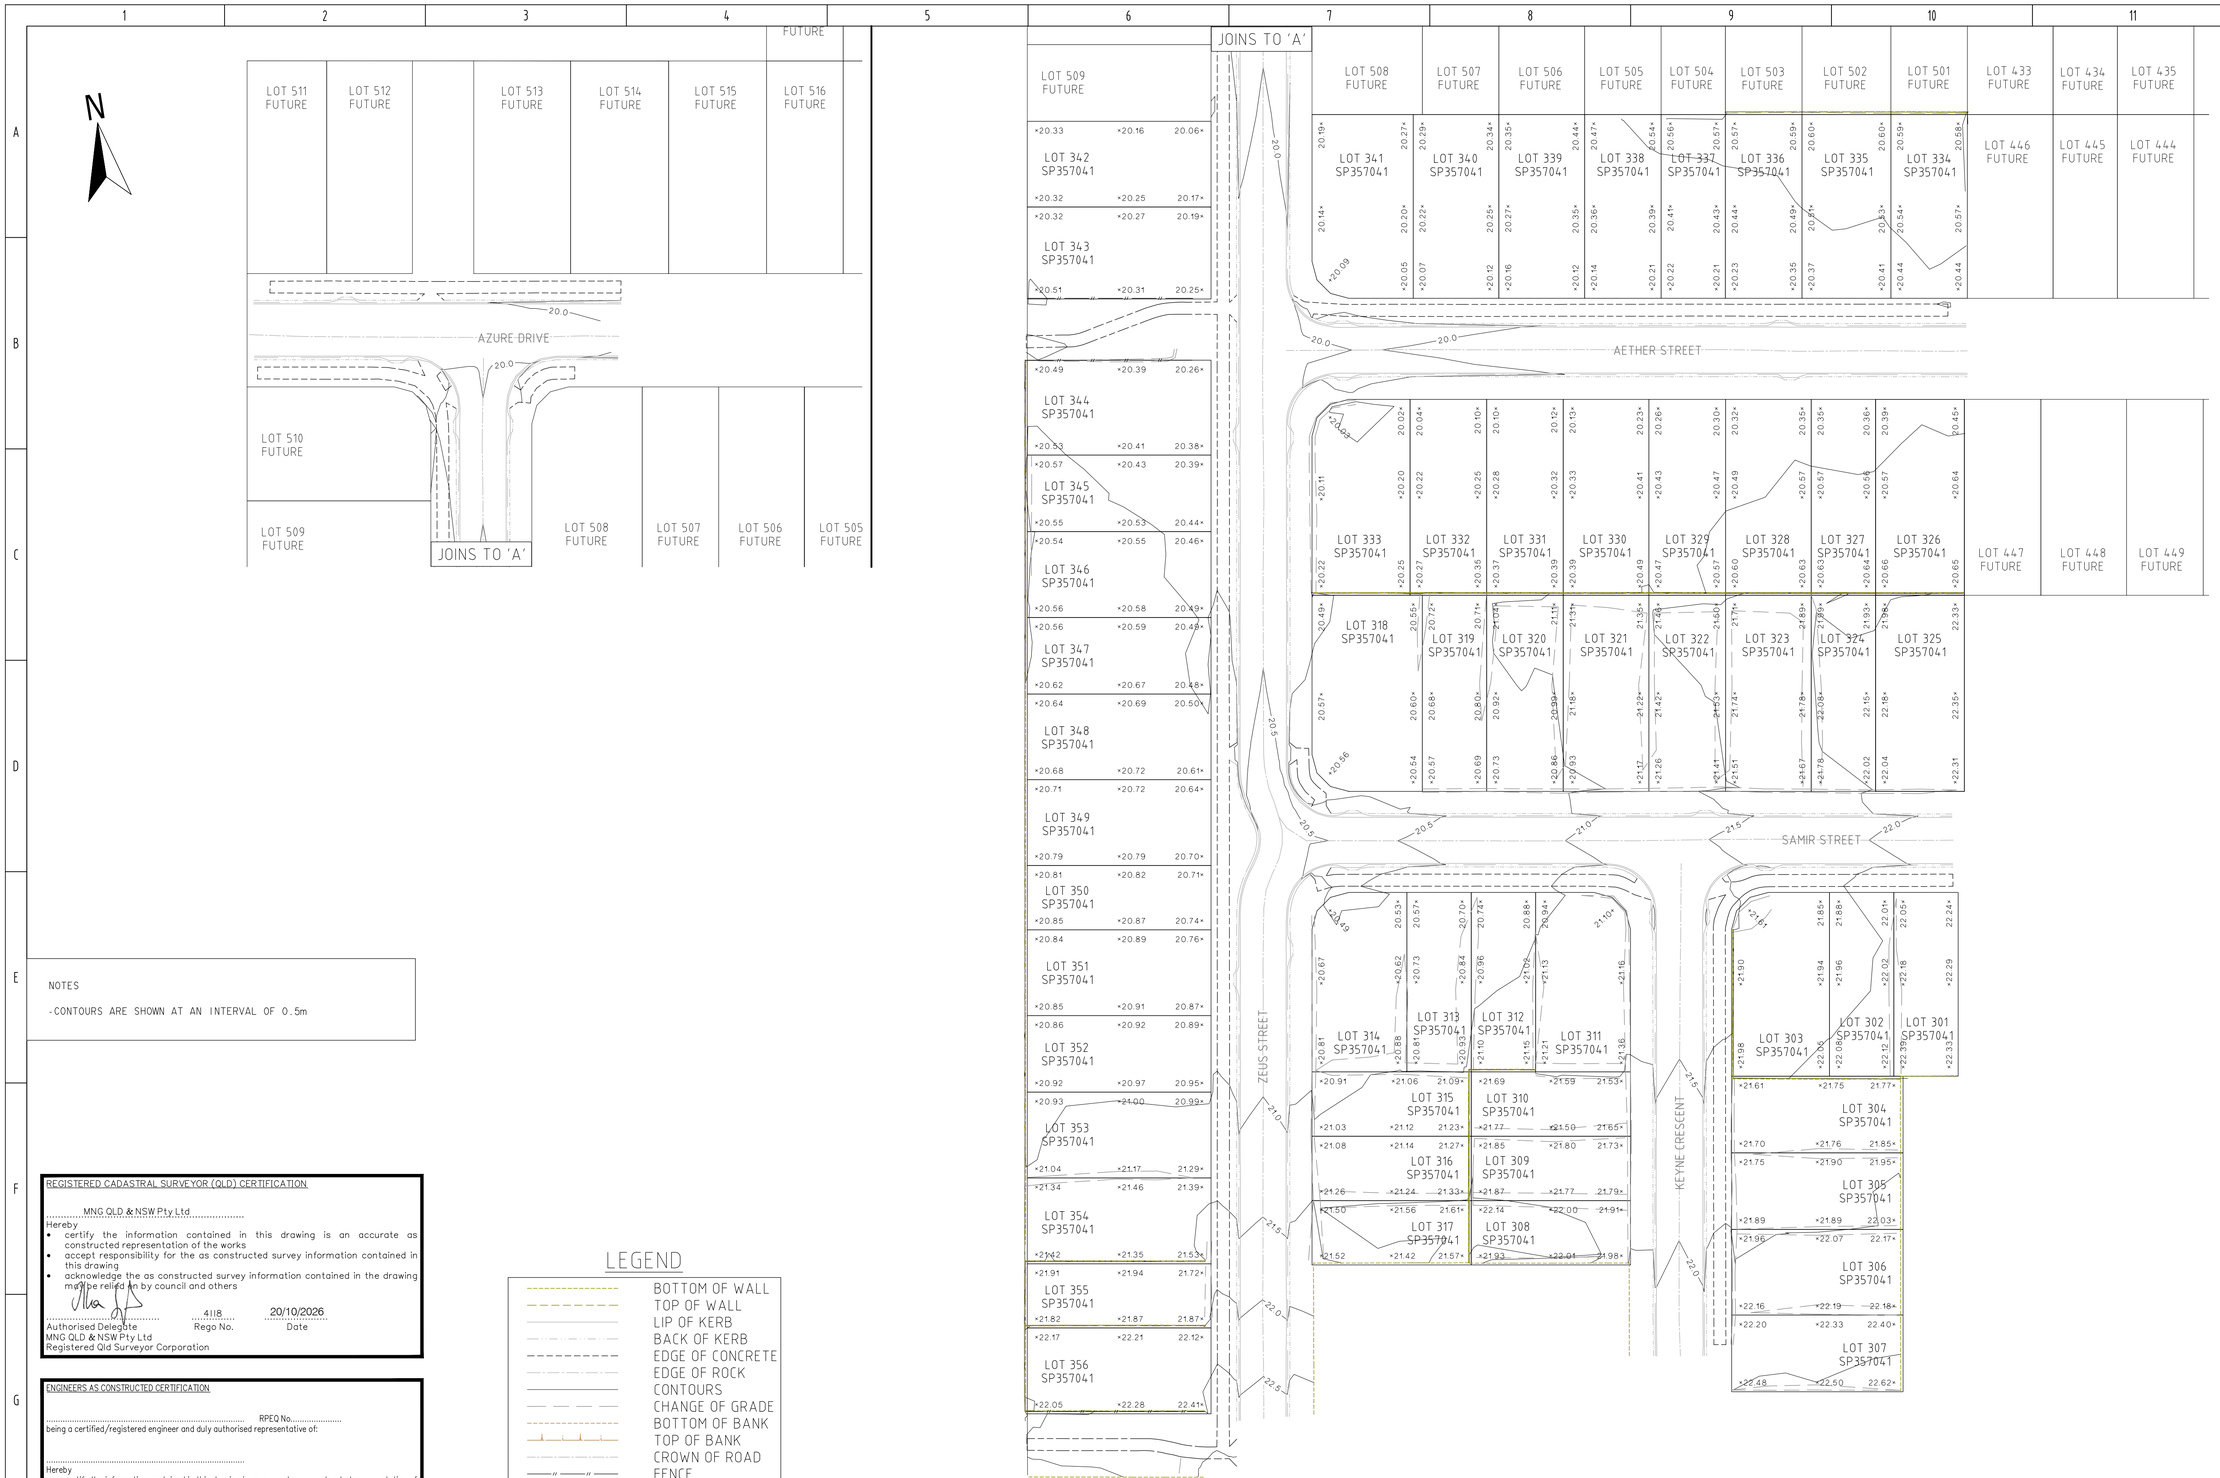


NOTES

- CONTOURS ARE SHOWN AT AN INTERVAL OF 0.5m

REGISTERED CADASTRAL SURVEYOR (QLD) CERTIFICATION

MNG QLD & NSW Pty Ltd

Hereby

- certify the information contained in this drawing is an accurate as constructed representation of the works
- accept responsibility for the as constructed survey information contained in this drawing
- acknowledge the as constructed survey information contained in the drawing may be relied on by council and others

Authorised Delegate | 4118 Rego No. | 20/10/2026 Date

MNG QLD & NSW Pty Ltd
Registered Qld Surveyor Corporation

ENGINEERS AS CONSTRUCTED CERTIFICATION

..... RPEQ No.....

being a certified/registered engineer and duly authorised representative of:

.....

Hereby

- certify the information contained in this drawing is an accurate as constructed representation of the works
- accept responsibility for the as constructed information contained in this drawing
- acknowledge the as constructed information contained in the drawing may be relied on by council and others

Certification of stage:..... by..... on.....

For.....

LEGEND

- BOTTOM OF WALL
- TOP OF WALL
- LIP OF KERB
- BACK OF KERB
- EDGE OF CONCRETE
- EDGE OF ROCK
- CONTOURS
- CHANGE OF GRADE
- BOTTOM OF BANK
- TOP OF BANK
- CROWN OF ROAD
- FENCE

DRAWING REVISIONS				DESIGN FILE No.		DESIGNED	
REV.	REVISION DESCRIPTION			CONSTRUCT. No.		DATE	
1	INITIAL ISSUE			SURVEY FILE No.		DRAWN	MJK
				FIELD BOOK		DATE	20/10/2026
				LOG BOOK		CHECKED	IS
				LEVEL DATUM		DATE	20/10/2026
				DATUM			

MNG
Brisbane Office
Level 3
108 Wickham Street
Fortitude Valley QLD 4006
p: (07) 3842 1000
e: brisbane@mngsurvey.com.au
w: mngsurvey.com.au
Perth | Brisbane | Melbourne | Sydney | Broome | South West WA

SCALE 1:500

ORIGINAL SIZE A1

Moreton Bay Regional Council
MORETON BAY REGIONAL COUNCIL
CABOOLTURE DISTRICT OFFICE
2 HASKING STREET CABOOLTURE QLD 4510
PO BOX 159 CABOOLTURE QLD 4510
Telephone: (07) 5433 0100
Fax: (07) 5433 4000

PROPOSED SUBDIVISION - STAGE 3
34 CRAIG ROAD, UPPER CABOOLTURE
AS CONSTRUCTED TOPOGRAPHY

SUBDIVISION REFERENCE	
DA/2022/1268	
PAGE NO. 1 OF 1	
MNG PLAN NUMBER	
BRSS7657-000-530-1	