PSM0722109
E: 490729.557
N: 7001736.656
RL: 30.422m

ENGINEER'S CERTIFICATION

I, ..., hereby certify that the as-constructed details shown on this drawing are a true and accurate record of the construction works, in compliance with the approved drawings and approved design.

_____
RPEQ (signature) RPEQ No. _____ Date:

REGISTERED SURVEYOR'S CERTIFICATION


I, MNG QLD & NSW Pty Ltd, hereby certify that the vertical and horizontal locations and dimensions shown on this plan are a true and correct record and were located by survey.

_____
Registered Surveyor (QLD) (sig.) Reg. Surveyor No. S4118 Date:

LEGEND

- SEWER END CAP
- SEWER WYE
- SEWER RADIAL BEND
- SEWER MAINTENANCE SHAFT
- SEWER MAINTENANCE HOLE

NOTES:
-ALL SEWER HOUSE CONNECTION PIPES ARE ø110 PE-100, CLASS 'SDR21' U.N.O.
-ALL SEWER RETICULATION PIPES ARE ø160 PE-100, CLASS 'SDR21' U.N.O.

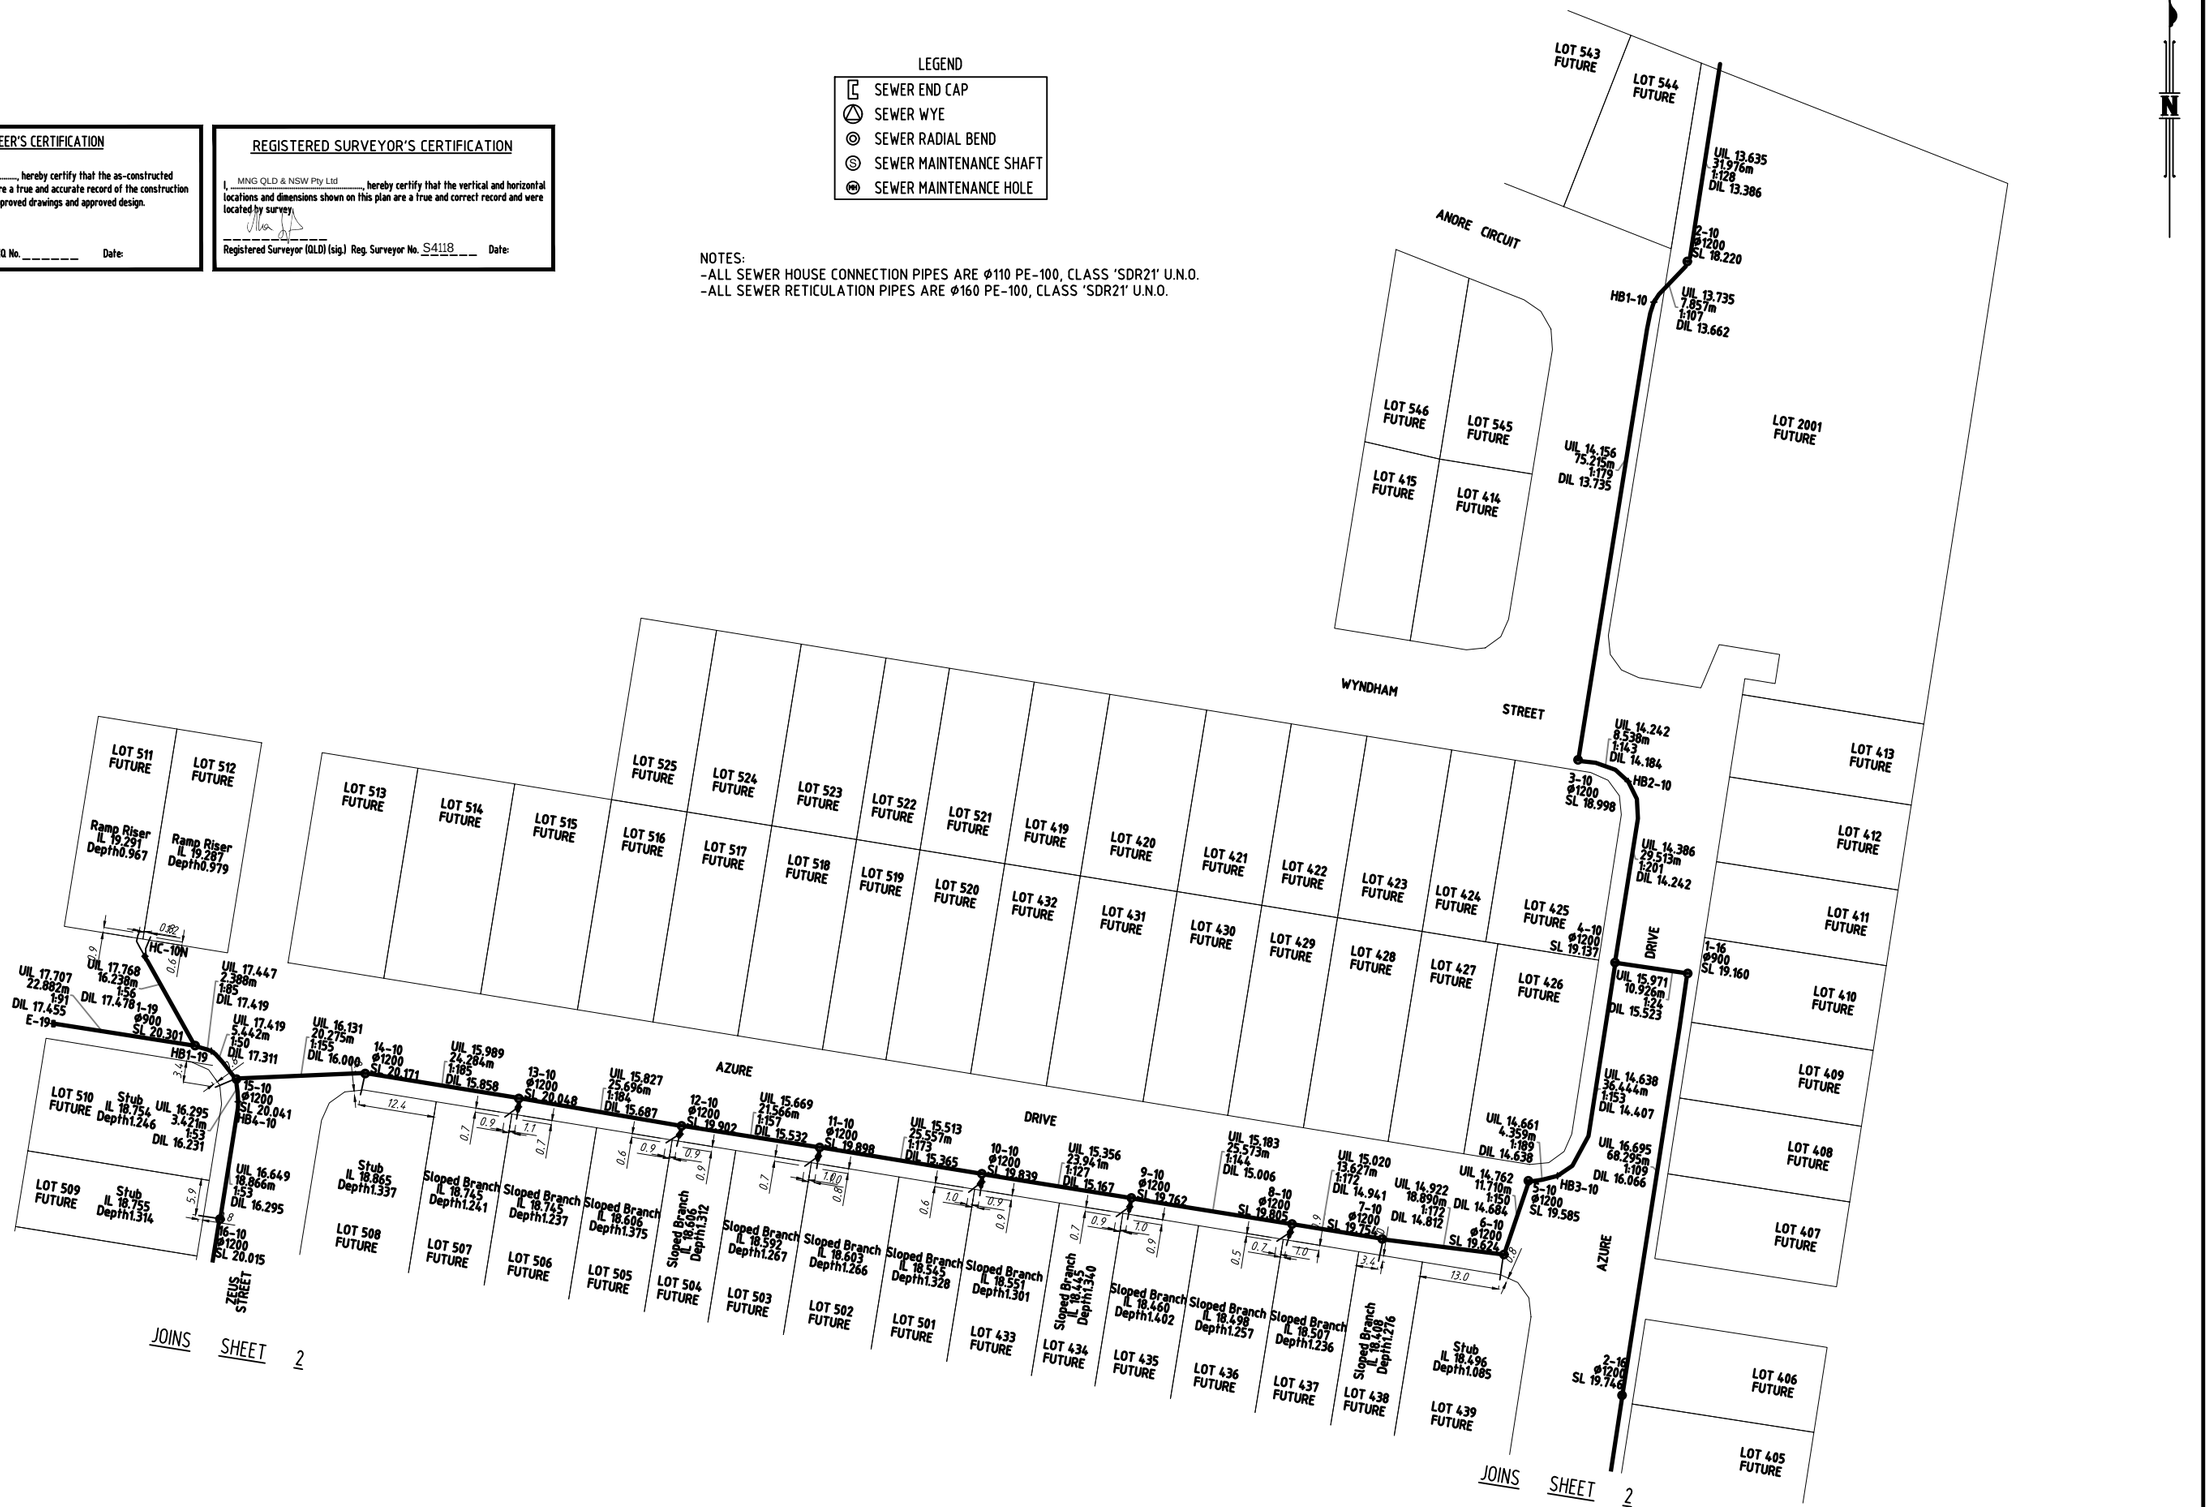

0 10 20 30 40 50m
SCALE 1:500 @A1

AS CONSTRUCTED

COORDINATE DATUM NOTE:

HORIZONTAL COORDINATES(E,N) SUPPLIED ARE MAPPING GRID OF AUSTRALIA(MGA), ZONE 56 BASED ON THE UNIVERSAL TRANSVERSE MERCATOR PROJECTION AND THE GEOCENTRIC DATUM OF AUSTRALIA 2020.

A1

INDEX	DATE	REVISIONS	DRAWN	CHECKED	PASSED
1	20/10/2026	INITIAL ISSUE	JHK	MJK	IS

	INITIALS	DATE
DRAWN	JHK	20/10/2026
CHECKED	MJK	20/10/2026
PASSED	IS	20/10/2026

MNG
Brisbane Office
Level 3
108 Wickham Street
Fortitude Valley QLD 4006
p: (07) 3842 1000
e: brisbane@mngsurvey.com.au
w: mngsurvey.com.au
Perth | Brisbane | Melbourne | Sydney | Broome | South West WA

Unitywater

Unitywater

APP-20053
Aire Development
Stage 3
As-Constructed Sewer

SHEET 1 OF 2	SHEETS	SCALE	1:500
REVISION DATE	20/10/2026	REVISION	1
DISCIPLINE CODE	C		
DRAWING NO.	U-2025-6263		

Copyright © 2011 Unitywater, All Rights Reserved

PSM0722109
E: 490729.557
N: 7001736.656
RL: 30.422m

JOINS SHEET 1

JOINS SHEET 1



JOINS SHEET 1

DIAGRAM A

Scale: 1:500

0 10 20 30 40 50m
SCALE 1:500 @A1

DIAGRAM A

NOTES:
-ALL SEWER HOUSE CONNECTION PIPES ARE ø110 PE-100, CLASS 'SDR21' U.N.O.
-ALL SEWER RETICULATION PIPES ARE ø160 PE-100, CLASS 'SDR21' U.N.O.

COORDINATE DATUM NOTE:
HORIZONTAL COORDINATES(E,N) SUPPLIED ARE MAPPING GRID OF AUSTRALIA(MGA), ZONE 56 BASED ON THE UNIVERSAL TRANSVERSE MERCATOR PROJECTION AND THE GEOCENTRIC DATUM OF AUSTRALIA 2020.

LEGEND
- SEWER END CAP
- SEWER WYE
- SEWER RADIAL BEND
- SEWER MAINTENANCE SHAFT
- SEWER MAINTENANCE HOLE

ENGINEER'S CERTIFICATION

I, ..., hereby certify that the as-constructed details shown on this drawing are a true and accurate record of the construction works, in compliance with the approved drawings and approved design.

RPEQ (signature) RPEQ No. _____ Date:

REGISTERED SURVEYOR'S CERTIFICATION

I, MNG QLD & NSW Pty Ltd, hereby certify that the vertical and horizontal locations and dimensions shown on this plan are a true and correct record and were located by survey.

Registered Surveyor (QLD) (sig.) Reg. Surveyor No. S4118 Date:

AS CONSTRUCTED

A1

INDEX	DATE	REVISIONS	DRAWN	CHECKED	PASSED
1	20/10/2026	INITIAL ISSUE	JHK	MJK	IS

	INITIALS	DATE
DRAWN	JHK	20/10/2026
CHECKED	MJK	20/10/2026
PASSED	IS	20/10/2026

MNG
Brisbane Office
Level 3
108 Wickham Street
Fortitude Valley QLD 4006
p: (07) 3842 1000
e: brisbane@mngsurvey.com.au
w: mngsurvey.com.au
Perth | Brisbane | Melbourne | Sydney | Broome | South West WA


Unitywater

Unitywater
APP-20053
Aire Development
Stage 3
As-Constructed Sewer

SHEET 1 OF 2 SHEETS | SCALE 1:500
REVISION DATE 20/10/2026 | REVISION 1
DISCIPLINE CODE C
DRAWING NO. U-2025-6263

Copyright © 2011 Unitywater, All Rights Reserved

PSM0722109
E: 490729.557
N: 7001736.656
RL: 30.422m

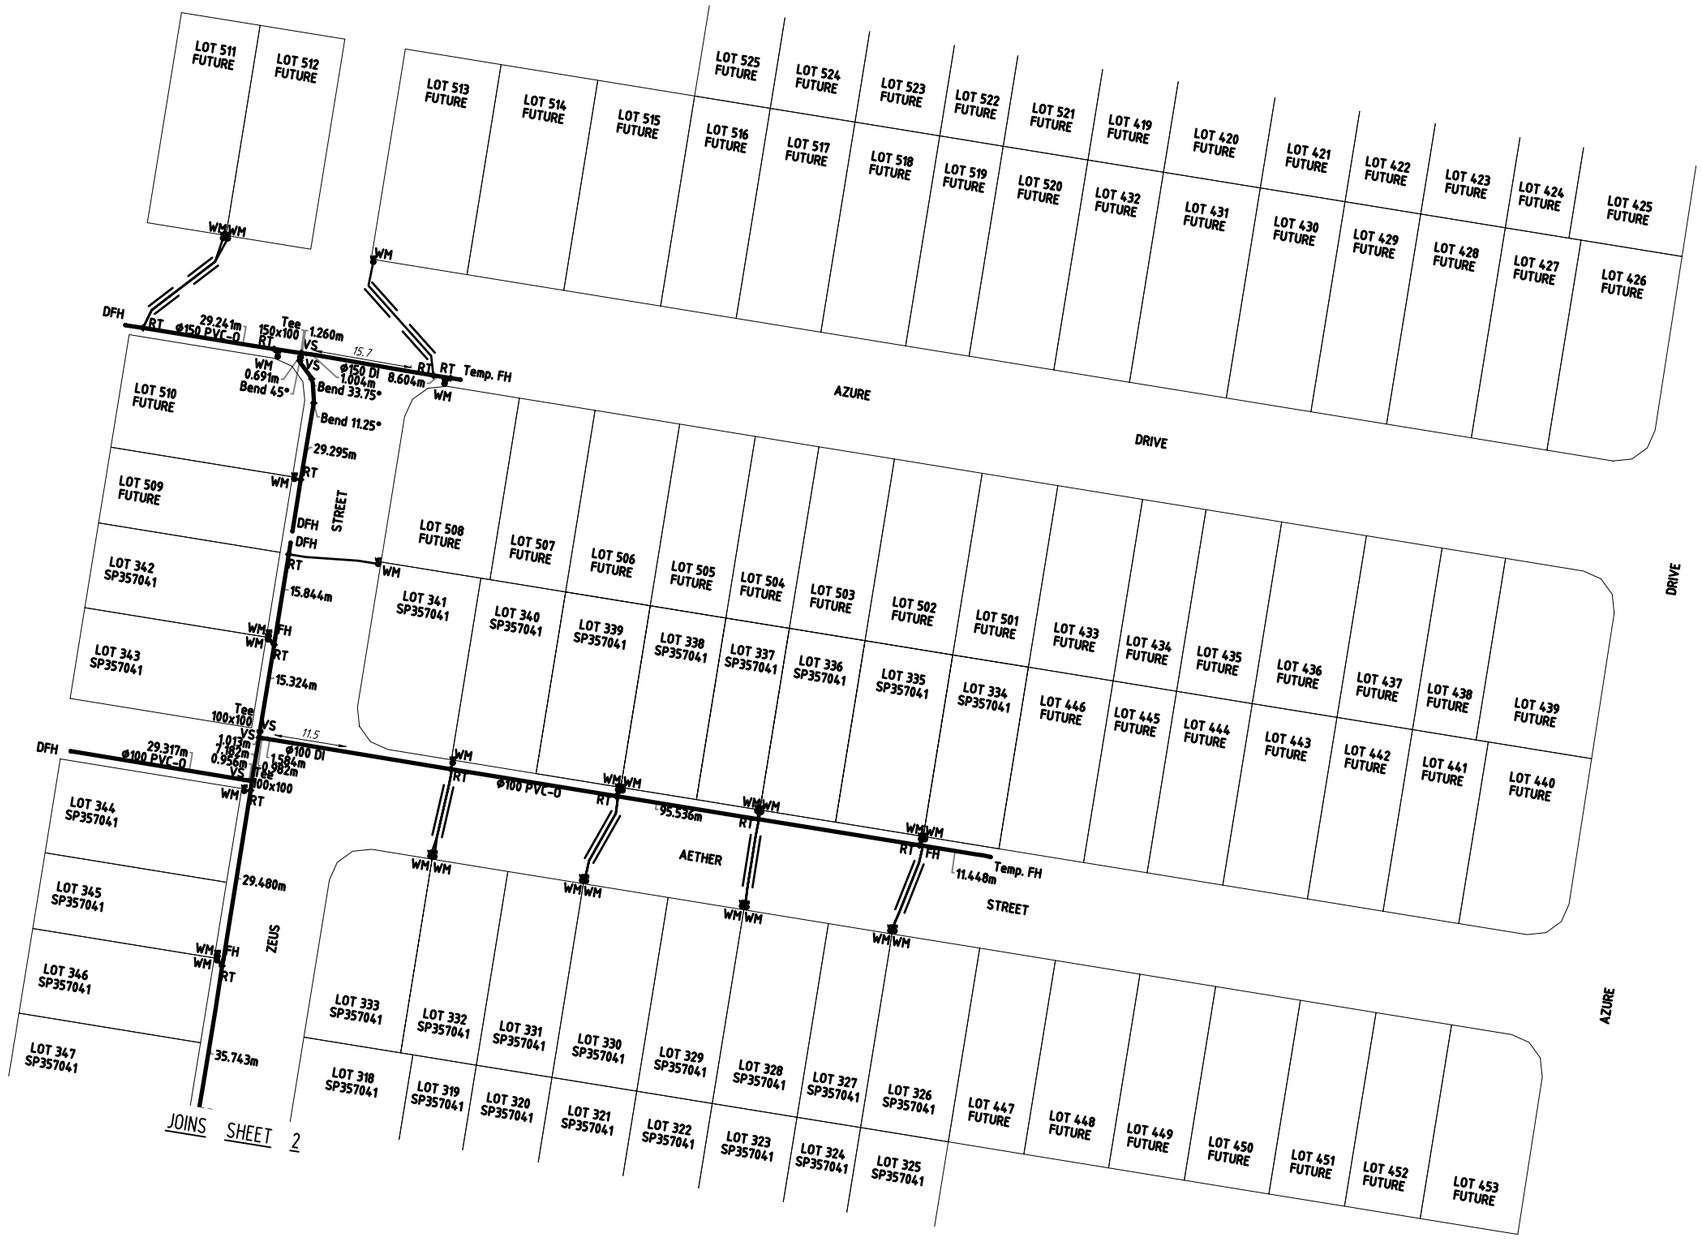

LEGEND

- (H) WATER FIRE HYDRANT
- (T) WATER TEE
- (M) WATER METER
- (B) WATER BEND
- WATER VALVE
- (R) WATER READY TAP
- WATER REDUCER
- CONDUIT/CROSSING

NOTES:
-WATER SERVICE CONDUIT CROSSINGS ARE ø100 PVC-U, CLASS 'PN9' AND SWJ.
-WATER SERVICE PIPES NOT CROSSING ROADS ARE ø25 PE AND CLASS 'PN16'.
-WATER SERVICE PIPES CROSSING ROADS ARE ø32 PE AND CLASS 'PN16'.

ENGINEER'S CERTIFICATION

I, _____, hereby certify that the as-constructed details shown on this drawing are a true and accurate record of the construction works, in compliance with the approved drawings and approved design.

_____
RPEQ (signature) RPEQ No. _____ Date:

REGISTERED SURVEYOR'S CERTIFICATION

I, MNG QLD & NSW Pty Ltd, hereby certify that the vertical and horizontal locations and dimensions shown on this plan are a true and correct record and were located by survey.

_____
Registered Surveyor (QLD) (sig.) Reg. Surveyor No. S4118 Date:

COORDINATE DATUM NOTE:
HORIZONTAL COORDINATES(E,N) SUPPLIED ARE MAPPING GRID OF AUSTRALIA(MGA), ZONE 56 BASED ON THE UNIVERSAL TRANSVERSE MERCATOR PROJECTION AND THE GEOCENTRIC DATUM OF AUSTRALIA 2020.

0 10 20 30 40 50m
SCALE 1:500 @A1

AS CONSTRUCTED

A1

INDEX	DATE	REVISIONS	DRAWN	CHECKED	PASSED
1	20/10/2026	INITIAL ISSUE	JHK	MJK	IS

	INITIALS	DATE
DRAWN	JHK	20/10/2026
CHECKED	MJK	20/10/2026
PASSED	IS	20/10/2026

MNG
Brisbane Office
Level 3
108 Wickham Street
Fortitude Valley QLD 4006
p: (07) 3842 1000
e: brisbane@mngsurvey.com.au
w: mngsurvey.com.au
Perth | Brisbane | Melbourne | Sydney | Broome | South West WA


Unitywater

Unitywater
APP-20053
Aire Development
Stage 3
As-Constructed Water

SHEET 1 OF 2 SHEETS	SCALE 1:500
REVISION DATE 20/10/2026	REVISION 1
DISCIPLINE CODE C	
DRAWING NO. U-2025-6263	

Copyright © 2011 Unitywater, All Rights Reserved

PSM0722109
E: 490729.557
N: 7001736.656
RL: 30.422m

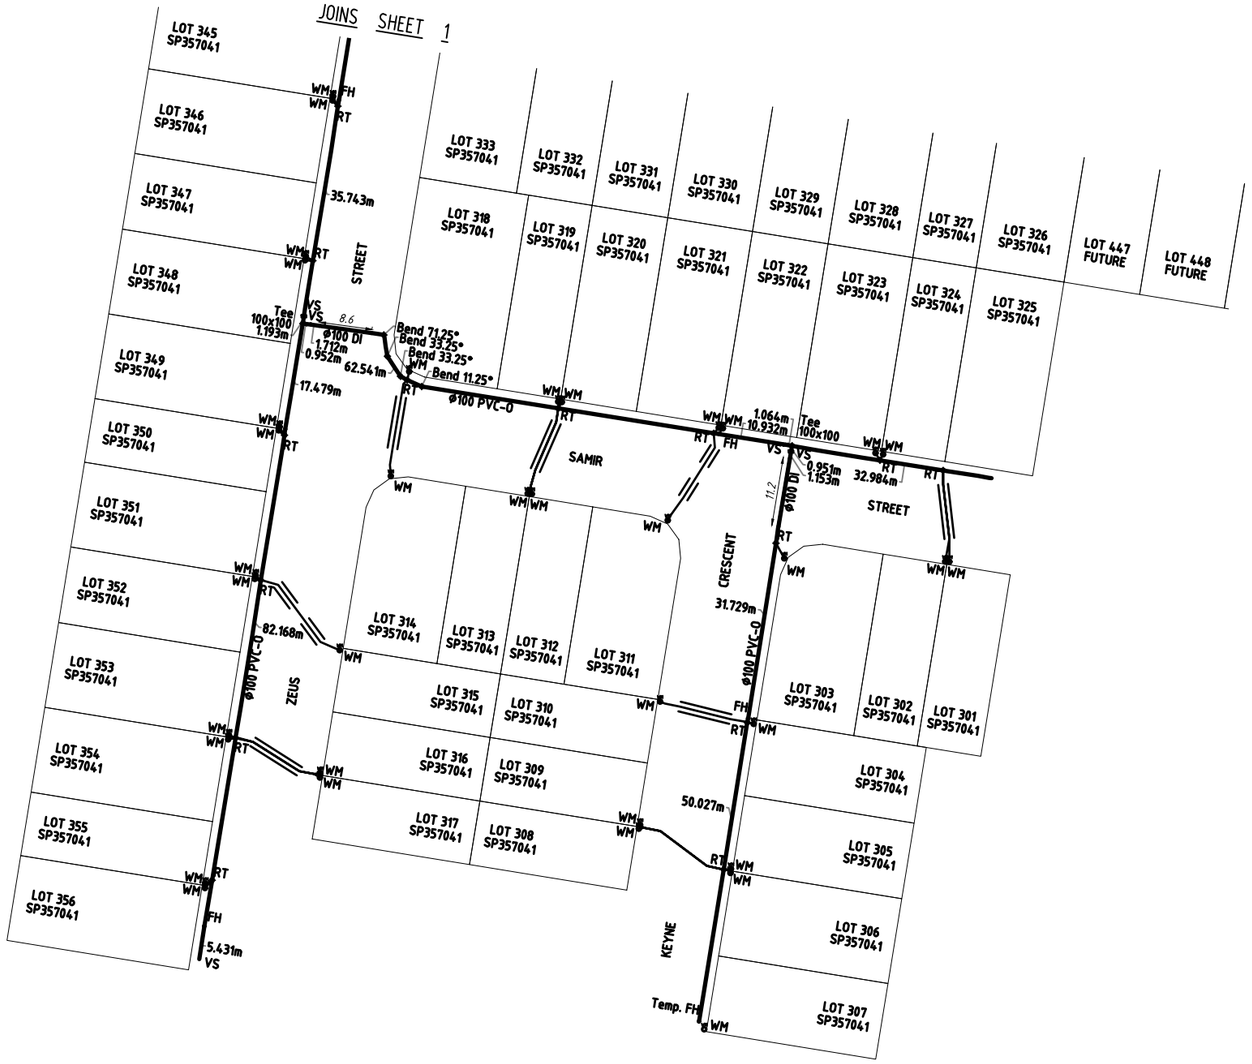

LEGEND

- (H) WATER FIRE HYDRANT
- (T) WATER TEE
- (M) WATER METER
- (B) WATER BEND
- WATER VALVE
- (R) WATER READY TAP
- WATER REDUCER
- CONDUIT/CROSSING

NOTES:
-WATER SERVICE CONDUIT CROSSINGS ARE ø100 PVC-U, CLASS 'PN9' AND SWJ.
-WATER SERVICE PIPES NOT CROSSING ROADS ARE ø25 PE AND CLASS 'PN16'.
-WATER SERVICE PIPES CROSSING ROADS ARE ø32 PE AND CLASS 'PN16'.

ENGINEER'S CERTIFICATION

I, ..., hereby certify that the as-constructed details shown on this drawing are a true and accurate record of the construction works, in compliance with the approved drawings and approved design.

_____
RPEQ (signature) RPEQ No. _____ Date:

REGISTERED SURVEYOR'S CERTIFICATION

I, ..., hereby certify that the vertical and horizontal locations and dimensions shown on this plan are a true and correct record and were located by survey.

_____
Registered Surveyor (QLD) (sig.) Reg. Surveyor No. _____ Date:

N

COORDINATE DATUM NOTE:
HORIZONTAL COORDINATES(E,N) SUPPLIED ARE MAPPING GRID OF AUSTRALIA(MGA), ZONE 56 BASED ON THE UNIVERSAL TRANSVERSE MERCATOR PROJECTION AND THE GEOCENTRIC DATUM OF AUSTRALIA 2020.

0 10 20 30 40 50m
SCALE 1:500 @A1

AS CONSTRUCTED

A1

INDEX	DATE	REVISIONS	DRAWN	CHECKED	PASSED
1	20/10/2026	INITIAL ISSUE	JHK	MJK	IS

	INITIALS	DATE
DRAWN	JHK	20/10/2026
CHECKED	MJK	20/10/2026
PASSED	IS	20/10/2026

MNG
Brisbane Office
Level 3
108 Wickham Street
Fortitude Valley QLD 4006
p: (07) 3842 1000
e: brisbane@mngsurvey.com.au
w: mngsurvey.com.au
Perth | Brisbane | Melbourne | Sydney | Broome | South West WA

Unitywater

Unitywater
APP-20053
Aire Development
Stage 3
As-Constructed Water

SHEET 2 OF 2 SHEETS	SCALE 1:500
REVISION DATE 20/10/2026	REVISION 1
DISCIPLINE CODE C	
DRAWING NO. U-2025-6263	

Copyright © 2011 Unitywater, All Rights Reserved