


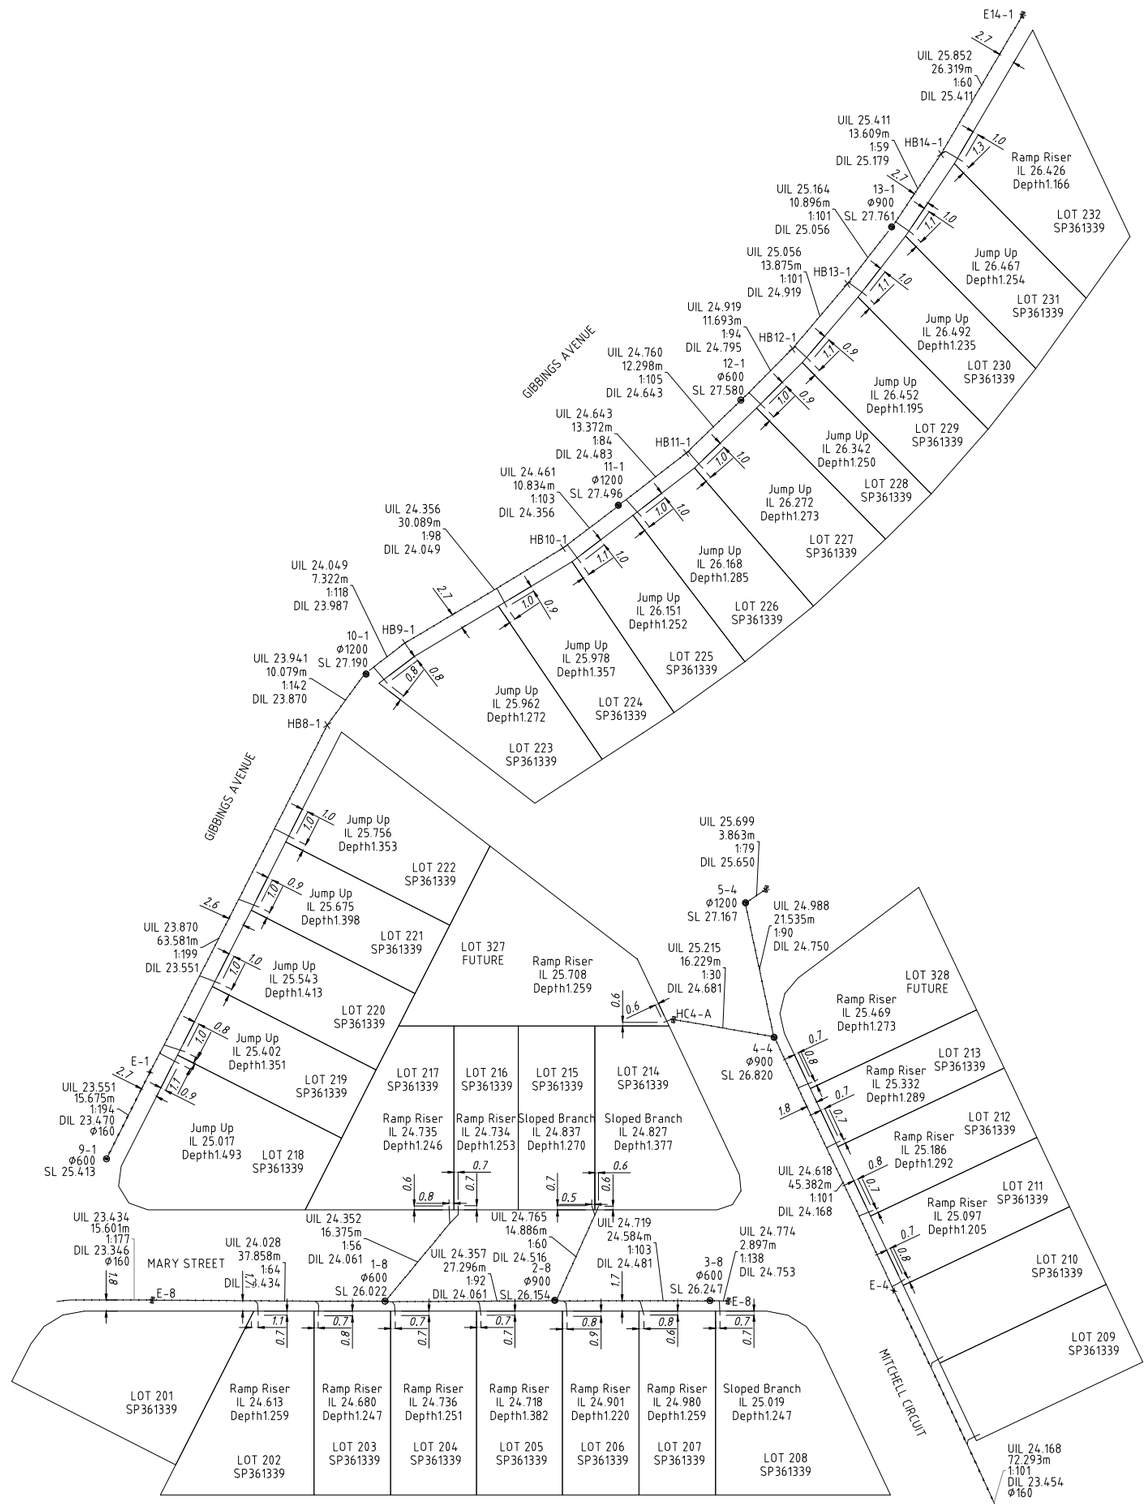

ENGINEER'S CERTIFICATION

I, _____, hereby certify that the as-constructed details shown on this drawing are a true and accurate record of the construction works, in compliance with the contract documents, approved drawings and approved design.

_____
RPEQ (signature) RPEQ No. _____ Date:

REGISTERED CADASTRAL SURVEYOR (QLD) CERTIFICATION

MNG QLD & NSW Pty Ltd, hereby certify that the vertical and horizontal locations and dimensions shown on this plan are a true and accurate record and were located by survey.

_____
Authorised Delegate Reg. Surveyor No. 4118 Date: 20/10/2026
MNG QLD & NSW Pty Ltd
Registered QLD Surveyor Corporation

COORDINATE DATUM NOTE:

HORIZONTAL COORDINATES(E,N) SUPPLIED ARE MAPPING GRID OF AUSTRALIA(MGA), ZONE 56 BASED ON THE UNIVERSAL TRANSVERSE MERCATOR PROJECTION AND THE GEOCENTRIC DATUM OF AUSTRALIA 2020.

0 10 20 30 40 50m
SCALE 1:500 @A1

AS CONSTRUCTED

A1

INDEX	DATE	REVISIONS	DRAWN	CHECKED	PASSED
2	20/10/2026	UPDATE OF DETAILS	VO	IS	IS
1	29/09/2026	INITIAL ISSUE	VO	LS	LS

	INITIALS	DATE
DRAWN	VO	20/10/2026
CHECKED	IS	20/10/2026
PASSED	IS	20/10/2026


MNG
Brisbane Office
Level 3
108 Wickham Street
Fortitude Valley QLD 4006
p: (07) 3842 1000
e: brisbane@mngsurvey.com.au
w: mngsurvey.com.au
Perth | Brisbane | Melbourne | Sydney | Broome | South West WA

Unitywater

Unitywater
APP-22520
26 Gibbings Court Lilywood QLD
Lilywood - Stage 2
AS-CONSTRUCTED SEWER

SHEET 1 OF 2 SHEETS		SCALE	1:500
REVISION DATE	20/10/2026	REVISION	2
DISCIPLINE CODE	C		
DRAWING NO.	U-2026-6391		

Copyright © 2011 Unitywater, All Rights Reserved

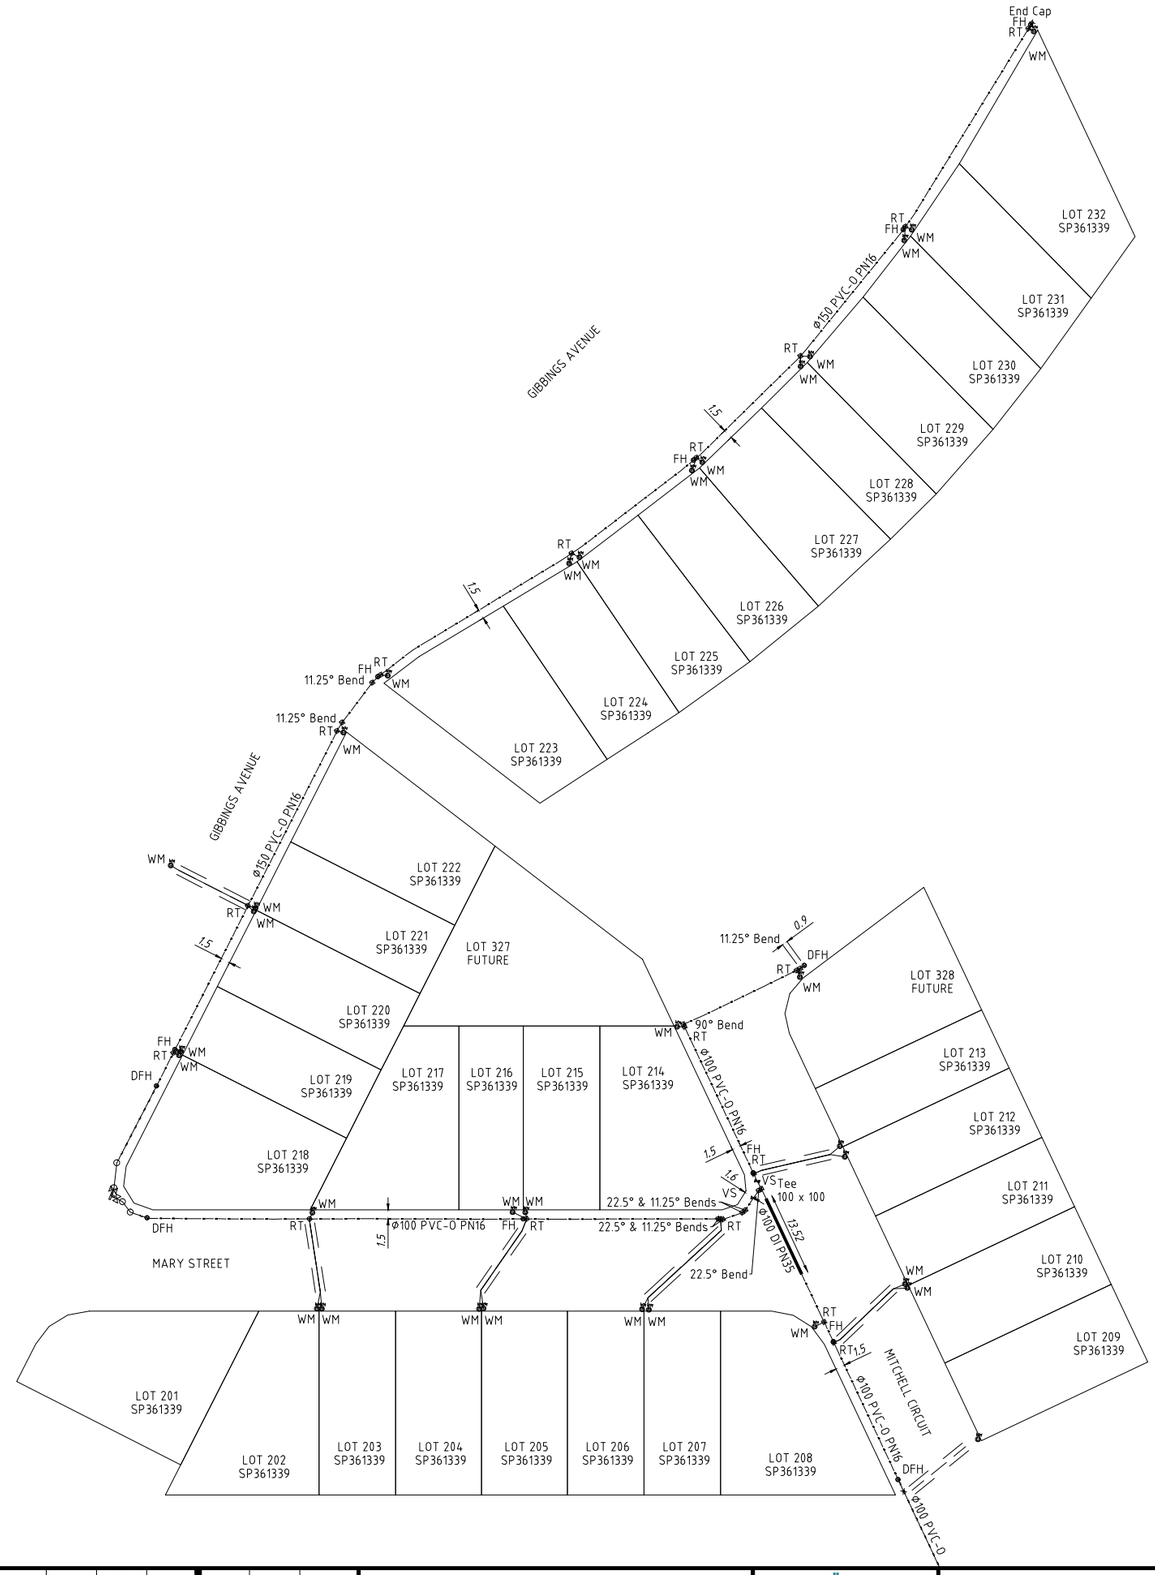

ENGINEER'S CERTIFICATION

I, ..., hereby certify that the as-constructed details shown on this drawing are a true and accurate record of the construction works, in compliance with the contract documents, approved drawings and approved design.

_____
RPEQ (signature) RPEQ No. _____ Date:

REGISTERED CADASTRAL SURVEYOR (QLD) CERTIFICATION

MNG QLD & NSW Pty Ltd, hereby certify that the vertical and horizontal locations and dimensions shown on this plan are a true and accurate record and were located by survey.

_____
Authorised Delegate Reg. Surveyor No. 4118 Date: 20/10/2026
MNG QLD & NSW Pty Ltd
Registered QLD Surveyor Corporation

COORDINATE DATUM NOTE:

HORIZONTAL COORDINATES(E,N) SUPPLIED ARE MAPPING GRID OF AUSTRALIA(MGA), ZONE 56 BASED ON THE UNIVERSAL TRANSVERSE MERCATOR PROJECTION AND THE GEOCENTRIC DATUM OF AUSTRALIA 2020.

0 10 20 30 40 50m
SCALE 1:500 @A1

AS CONSTRUCTED

A1

INDEX	DATE	REVISIONS	DRAWN	CHECKED	PASSED
2	20/10/2026	UPDATE OF DETAILS	VO	IS	IS
1	29/09/2026	INITIAL ISSUE	VO	LS	LS

	INITIALS	DATE
DRAWN	VO	20/10/2026
CHECKED	IS	20/10/2026
PASSED	IS	20/10/2026

MNG
Brisbane Office
Level 3
108 Wickham Street
Fortitude Valley QLD 4006
p: (07) 3842 1000
e: brisbane@mngsurvey.com.au
w: mngsurvey.com.au
Perth | Brisbane | Melbourne | Sydney | Broome | South West WA

Unitywater

Unitywater
APP-22520
26 Gibbings Court Lilywood QLD
Lilywood - Stage 2
AS-CONSTRUCTED WATER

SHEET 2 OF 2 SHEETS		SCALE 1:500	
REVISION DATE	20/10/2026	REVISION	2
DISCIPLINE CODE	C		
DRAWING NO.	U-2026-6391		

Copyright © 2011 Unitywater, All Rights Reserved